



DESIGNER
SPILLS CANDELA DMJM
 800 DOUGLAS ENTRANCE, SUITE 200
 CORAL GABLES, FL 33134
 T: 305-444-6658 F: 305-447-3580
 www.spillscondeladmjm.com
 FLORIDA LICENSE AA0003298

CONSULTANTS

LANDSCAPE ARCHITECTURE
SAVINO & MILLER DESIGN STUDIO
 1245 NE 5TH AVENUE, MIAMI, FLORIDA 33136
 TEL: (305) 887-9827 FAX: (305) 885-3083

ESTIMATING CONSULTANT
ONS CONSTRUCTION MANAGEMENT SERVICES
 10 BUNKER HILL DRIVE, SUITE 300, MIAMI, FLORIDA 33142
 TEL: (954) 481-1811 FAX: (954) 472-3142

COASTAL CONSTRUCTION
EDCO CORPORATION
 7465 SW 27TH AVENUE, MIAMI, FLORIDA 33156
 TEL: (305) 888-4100 FAX: (305) 888-4180

FOOD SERVICES CONSULTANT
STAVAS DESIGN INTERNATIONAL
 14100 N.W. 27TH AVENUE, SUITE 200, MIAMI, FLORIDA 33157
 TEL: (954) 315-3555 FAX: (954) 728-8111


POOL CONSULTANT
AQUADYNAMICS, INC.
 5000 SW 72ND AVENUE, SUITE 202, MIAMI, FLORIDA 33156
 TEL: (305) 887-8875 FAX: (305) 882-0022

LEED CONSULTANT
SPINNAKER GROUP, INC.
 501 SPINNAKER, WESTON, FL 33326
 TEL: (954) 341-8867 FAX: (954) 217-3814


PROFESSIONAL OF RECORD: JESUS CRUZ
 DISCIPLINE: ARCHITECTURE
 REGISTRATION NO. AR0006906

ISSUE	DATE	DESCRIPTION
Δ	03-01-10	CITY REVIEW COMMENTS

MARK	DATE	DESCRIPTION
PROJECT NO:		60028604
DRAWN BY:		
CHECKED BY:		
DATE:		10-22-2009
KEY PLAN		

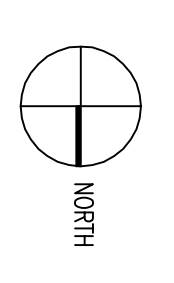

1 | GROUND FLOOR FINISH PLAN
 1/8" = 1'-0"

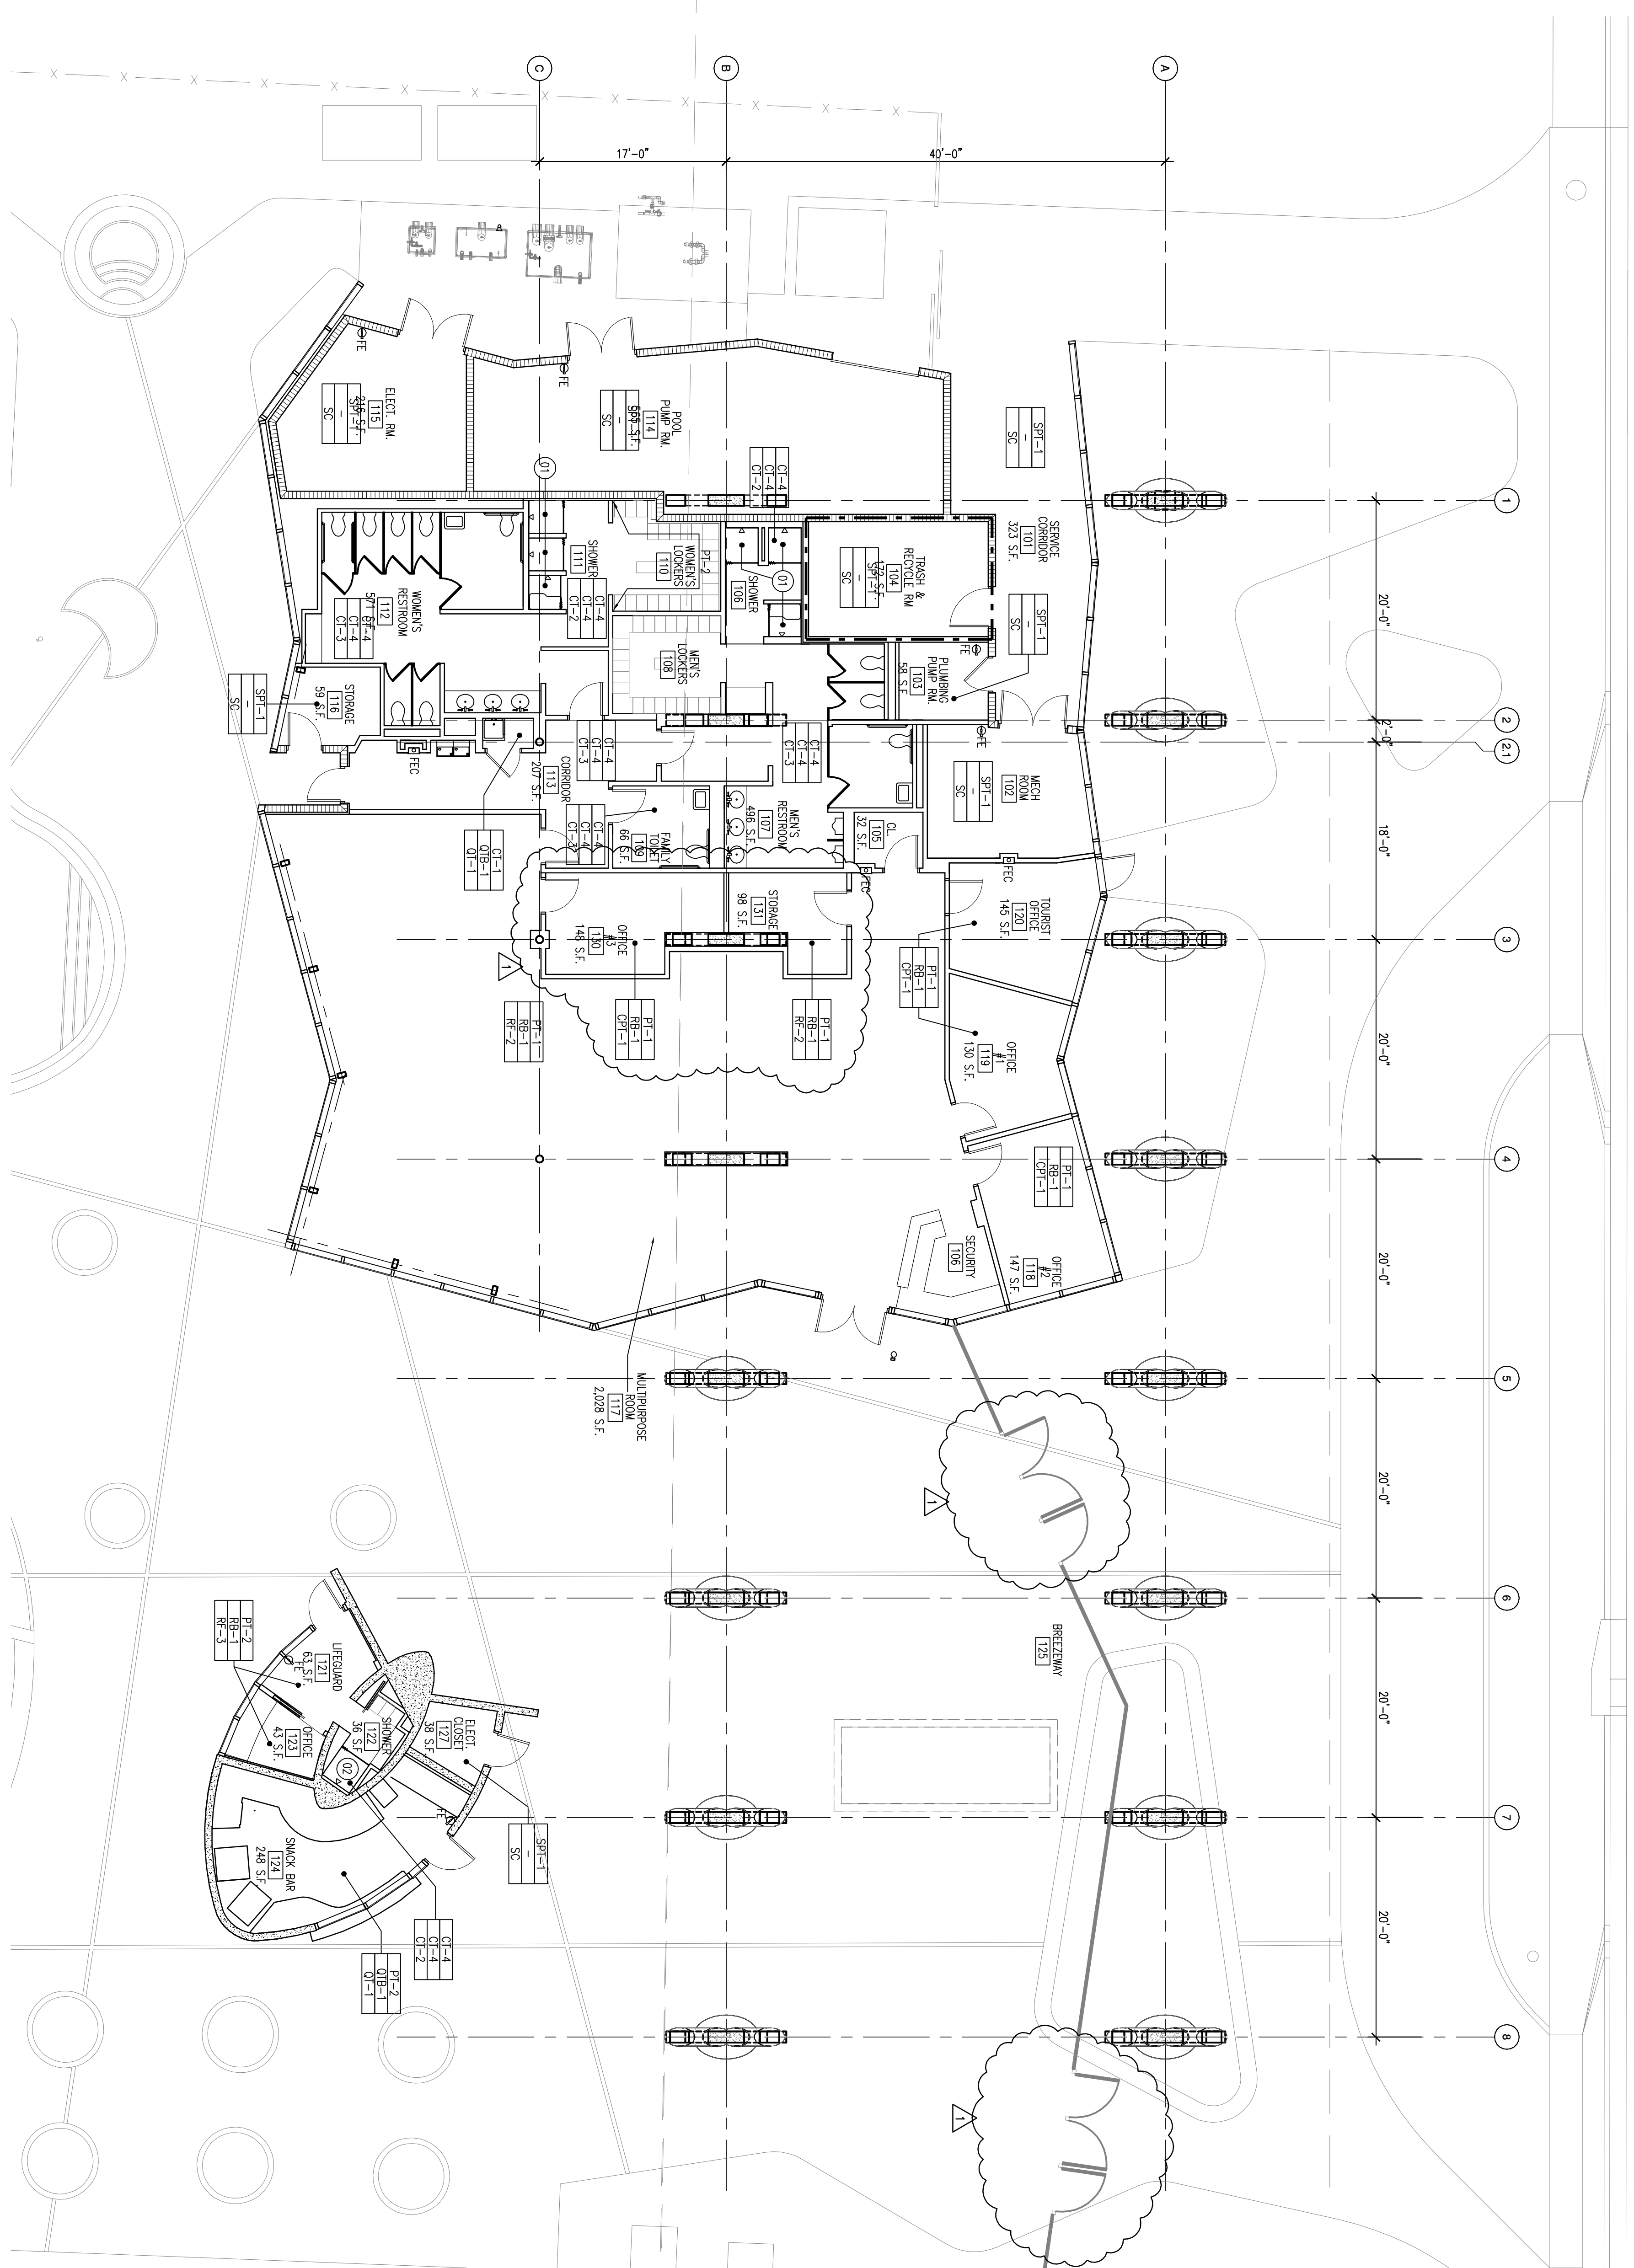

FINISH GENERAL NOTES:

1. FINISHES SHALL BE INSTALLED IN ACCORDANCE WITH THE MANUFACTURER'S INSTRUCTIONS.
2. ALL ROOMS AND OFFICES TO RECEIVE WINDOW INSULATION W/1-1.
3. PLEASE REFER TO SPECIFICATIONS FOR DESCRIPTION OF MATERIALS.

FINISH KEY NOTES:

- ① SHOWER FINISHES: WALLS C-1-1, BASE C-1-1, FLOOR C-1-2
- ② SHOWER FINISHES: WALLS C-1-1, BASE C-1-1, FLOOR C-1-2

FINISH CODES

C-1-1	WALL FINISH
C-1-2	BASE FINISH
F-1-1	FLOOR FINISH
C-1-3	CEILING FINISH
C-1-4	CEILING FINISH
C-1-5	CEILING FINISH
C-1-50	CEILING FINISH

